

Date: Wednesday, 7/5/2006 2:50:05 PM  
 User: Kim Johnston

## Process Sheet

Customer : CU-DAR001 Dart Helicopters Services Drawing Name : 350/212/130 BASKET LID  
 Job Number : 27816B  
 Estimate Number : 10193  
 P.O. Number : N/A Part Number : D2512  
 This Issue : 7/5/2006 S.O. No. : N/A Drawing Number : D2512 REV D2  
 Prsht Rev. : NC Project Number : N/A  
 First Issue : N/A Type : LARGE FAB ASSY Drawing Revision : D2  
 Previous Run : 27815B Material : N/A  
 Written By : *See comment below* Due Date : 7/30/2006 Qty: 1 Um: Each  
 Checked & Approved By : *06.07.05*  
 Comment : Rev Est:M 03.01.31 Added D2012-117 for D130-701-041 KJ/  
 RF  
 Est Rev:N 06.04.05 Added level21 EC

## Additional Product

Job Number:



Seq. #: Machine Or Operation: Description :

1.0 M304TS0750W065 304 SQ Tube.75x.75x.065W



Comment: Qty.: 45.7594 f(s)/Unit Total : 45.7594 f(s)

Pick:

3/4"x3/4" 304/316 SS tube .063" wall

Batch: *M101309**518,53**CPL 06.07.18*

2.0 D31663 Basket Hoop



Comment: Qty.: 1.0000 Each(s)/Unit Total : 1.0000 Each(s)

Pick:

Qty Part Number Description

1 D3166-3 Basket Hoop

Batch

*B27327**CPL 06.07.18*

3.0 D2506 Placard



Comment: Qty.: 1.0000 Each(s)/Unit Total : 1.0000 Each(s)

Pick:

Qty Part Number Description

1 D2506 Label Plate

Batch

*B26631-2**CPL 06.07.18*

4.0 D23271 Spacer Bushing



Comment: Qty.: 2.0000 Each(s)/Unit Total : 2.0000 Each(s)

Pick:

Qty Part Number Description

2 D2327-1 Bushing

Batch

*B26742**CPL 06.07.18*

W/O:		WORK ORDER CHANGES					
DATE	STEP	PROCEDURE CHANGE	By	Date	Qty	Approval Mfg / Design Mgr	Approval QC Inspector

NCR:		WORK ORDER NON-CONFORMANCE (NCR)						
DATE	STEP	Description of NC Section A	Corrective Action Section B			Verification Section C	Approval Design Mgr	Approval QC Inspector
			Initial Design Mgr	Action Description Design Mgr	Sign & Date			

Part No: \_\_\_\_\_ PAR #: \_\_\_\_\_ Fault Category: \_\_\_\_\_ NCR: Yes No DQA: \_\_\_\_\_ Date: \_\_\_\_\_

NOTE: Date & initial all entries

QA: N/C Closed: \_\_\_\_\_ Date: \_\_\_\_\_

Date: Wednesday, 7/5/2006 2:50:05 PM  
User: Kim Johnston

## Process Sheet

Customer: CU-DAR001 Dart Helicopters Services

Drawing Name: 350/212/130 BASKET LID

Job Number: 27816B

Part Number: D2512

Job Number:



Seq. #:

Machine Or Operation:

Description :

5.0

D22321

Hinge



Comment: Qty.: 2.0000 Each(s)/Unit Total: 2.0000 Each(s)

Pick:

Qty Part Number

Description

Batch

2 D2232-1

Hinge plate

325238

CPL 06-07-18

6.0

D2581

Mounting Bracket



Comment: Qty.: 2.0000 Each(s)/Unit Total: 2.0000 Each(s)

Pick:

Qty Part Number

Description

Batch

2 D2581

Mounting Bracket

327524

CPC 06-07-18

7.0

M304EX07516F

Expanded Metal Flat Stai



Comment: Qty.: 18.0000 sf(s)/Unit Total: 18.0000 sf(s)

Pick:

Qty Part Number

Description

Batch

18 sf M304EX0.75-16F Expanded Metal

M101341

CPL 06-07-24

8.0

LARGE FAB 1

LARGE FABRICATION RESOURCE 1



Comment: LARGE FABRICATION RESOURCE 1

1-Cut 3/4" x 3/4" square tubing as per Dwg D2512

2-Cut (4) D2236 From D3166-3

3-Drill holes in D2512-1 as per Dwg D2512 using Drill Jig DT8305

5-Weld as per Dwg D2512 using Welding Table and corner Jig Deburr as required

CPL 06-07-24

9.0

QC9/6

DDIMENSIONAL & WELDING INSPECTION



Comment: DDIMENSIONAL & WELDING INSPECTION

11 06/07/27 (1)

W/O:		WORK ORDER CHANGES					
DATE	STEP	PROCEDURE CHANGE	By	Date	Qty	Approval Mfg / Design Mgr	Approval QC Inspector

NCR:		WORK ORDER NON-CONFORMANCE (NCR)						
DATE	STEP	Description of NC Section A	Corrective Action Section B			Verification Section C	Approval Design Mgr	Approval QC Inspector
			Initial Design Mgr	Action Description Design Mgr	Sign & Date			

Part No: \_\_\_\_\_ PAR #: \_\_\_\_\_ Fault Category: \_\_\_\_\_ NCR: Yes ☒ No ☐ DQA: DD Date: 06/08/03

NOTE: Date & initial all entries

QA: N/C Closed: \_\_\_\_\_ Date: \_\_\_\_\_

Date: Wednesday, 7/5/2006 2:50:05 PM  
User: Kim Johnston

## Process Sheet

Customer: CU-DAR001 Dart Helicopters Services

Drawing Name: 350/212/130 BASKET LID

Job Number: 27816B

Part Number: D2512

Job Number:



Seq. #:

Machine Or Operation:

Description :

10.0

POWDER COATING

POWDER COATING



Comment: POWDER COATING

Powder Coat White Gloss (Ref: 4.3.5.1) as per QSI 005 4.3

SC  
PC

06/07/27

①

11.0

HAND FINISHING1

HAND FINISHING RESOURCE #1



Comment: HAND FINISHING RESOURCE #1

Wing Walk and Spray Paint black as per Dwg D2512 and QSI 005 4.4

Batch: 001667

FC 06 07 27

12.0

QC3

INSPECT POWDER COAT/CHEMICAL CONVERSION



Comment: INSPECT POWDER COAT/CHEMICAL CONVERSION

06 08 01

13.0

PACKAGING 1

PACKAGING RESOURCE #1



Comment: PACKAGING RESOURCE #1

Identify and Stock

Location:

14.0

DC

DOCUMENT CONTROL



Comment: DOCUMENT CONTROL

Inspection Level 21

06/08/03 ①

Job Completion



C 206108102

W/O:		WORK ORDER CHANGES					
DATE	STEP	PROCEDURE CHANGE	By	Date	Qty	Approval Mfg / Design Mgr	Approval QC Inspector

NCR:		WORK ORDER NON-CONFORMANCE (NCR)						
DATE	STEP	Description of NC Section A	Corrective Action Section B			Verification Section C	Approval Design Mgr	Approval QC Inspector
			Initial Design Mgr	Action Description Design Mgr	Sign & Date			

Part No: \_\_\_\_\_ PAR #: \_\_\_\_\_ Fault Category: \_\_\_\_\_ NCR: Yes No DQA: \_\_\_\_\_ Date: \_\_\_\_\_

NOTE: Date & initial all entries

QA: N/C Closed: \_\_\_\_\_ Date: \_\_\_\_\_




DESIGN BW	DRAWN BY CP	DART AEROSPACE LTD HAWKESBURY, ONTARIO, CANADA	
CHECKED #	APPROVED #	DRAWING NO. D2512	REV. D SHEET 1 OF 4
DATE 01.04.19		TITLE BASKET LID ASSEMBLY (350/212) SCALE NTS	
A	95.11.21	NEW ISSUE	
B	96.05.24	ADDED LATCH CHANNEL & LABEL PLATE	
C	99.07.06	REMOVE DOUBLE SKIN SECTION, ADDED MEMBERS, INCORP. DEO 9074	
D	01.04.19	CHANGE HINGE	
D1	CP 03.01.20	ADD D2012-117 FOR D130-701-041	
D2	CP 09.09.20	TACK WELD ANT-SKID AREA	

RELEASED  
01.04.27 #

PARTS LIST FOR D2512 BASKET LID ASSEMBLY

PART NO	QUANTITY	LENGTH A	LENGTH B	DESCRIPTION
D2512-1	2	—	25.50	RIB
D2512-3	2	—	95.30	RIB
D2512-5	6	30.84	—	RIB
D2512-7	3	30.63	—	RIB
D2232-1	2	N/A	N/A	HINGE PLATE
D2236	4	N/A	N/A	RIB
D2327-1	2	N/A	N/A	BUSHING
D2506	1	N/A	N/A	LABEL PLATE
D2581	2	N/A	N/A	MOUNTING BRKT

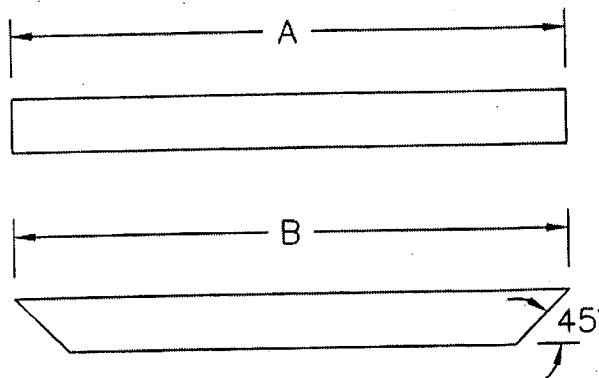

SHOP COPY  
RETURN TO  
ENGINEERING  
UNCONTROLLED COPY  
SUBJECT TO AMENDMENT  
WITHOUT NOTICE  
WORK ORDER  
NO. 27816B

D2512-1/-3/-5/-7

CUT LENGTH/SHAPE PER DIAGRAM AND PARTS LIST


MATERIAL: AISI 304/316 SS, 3/4 X 3/4 X 0.060 WALL SQUARE TUBING

TOLERANCES ARE PER DART QSI 018 UNLESS OTHERWISE NOTED

ALL DIMENSIONS ARE IN INCHES

Copyright © 1995 by DART AEROSPACE LTD

THIS DOCUMENT IS PRIVATE AND CONFIDENTIAL AND IS SUPPLIED ON THE EXPRESS CONDITION THAT IT IS NOT TO BE USED FOR ANY PURPOSE OR COPIED OR COMMUNICATED TO ANY OTHER PERSON WITHOUT WRITTEN PERMISSION FROM DART AEROSPACE LTD.

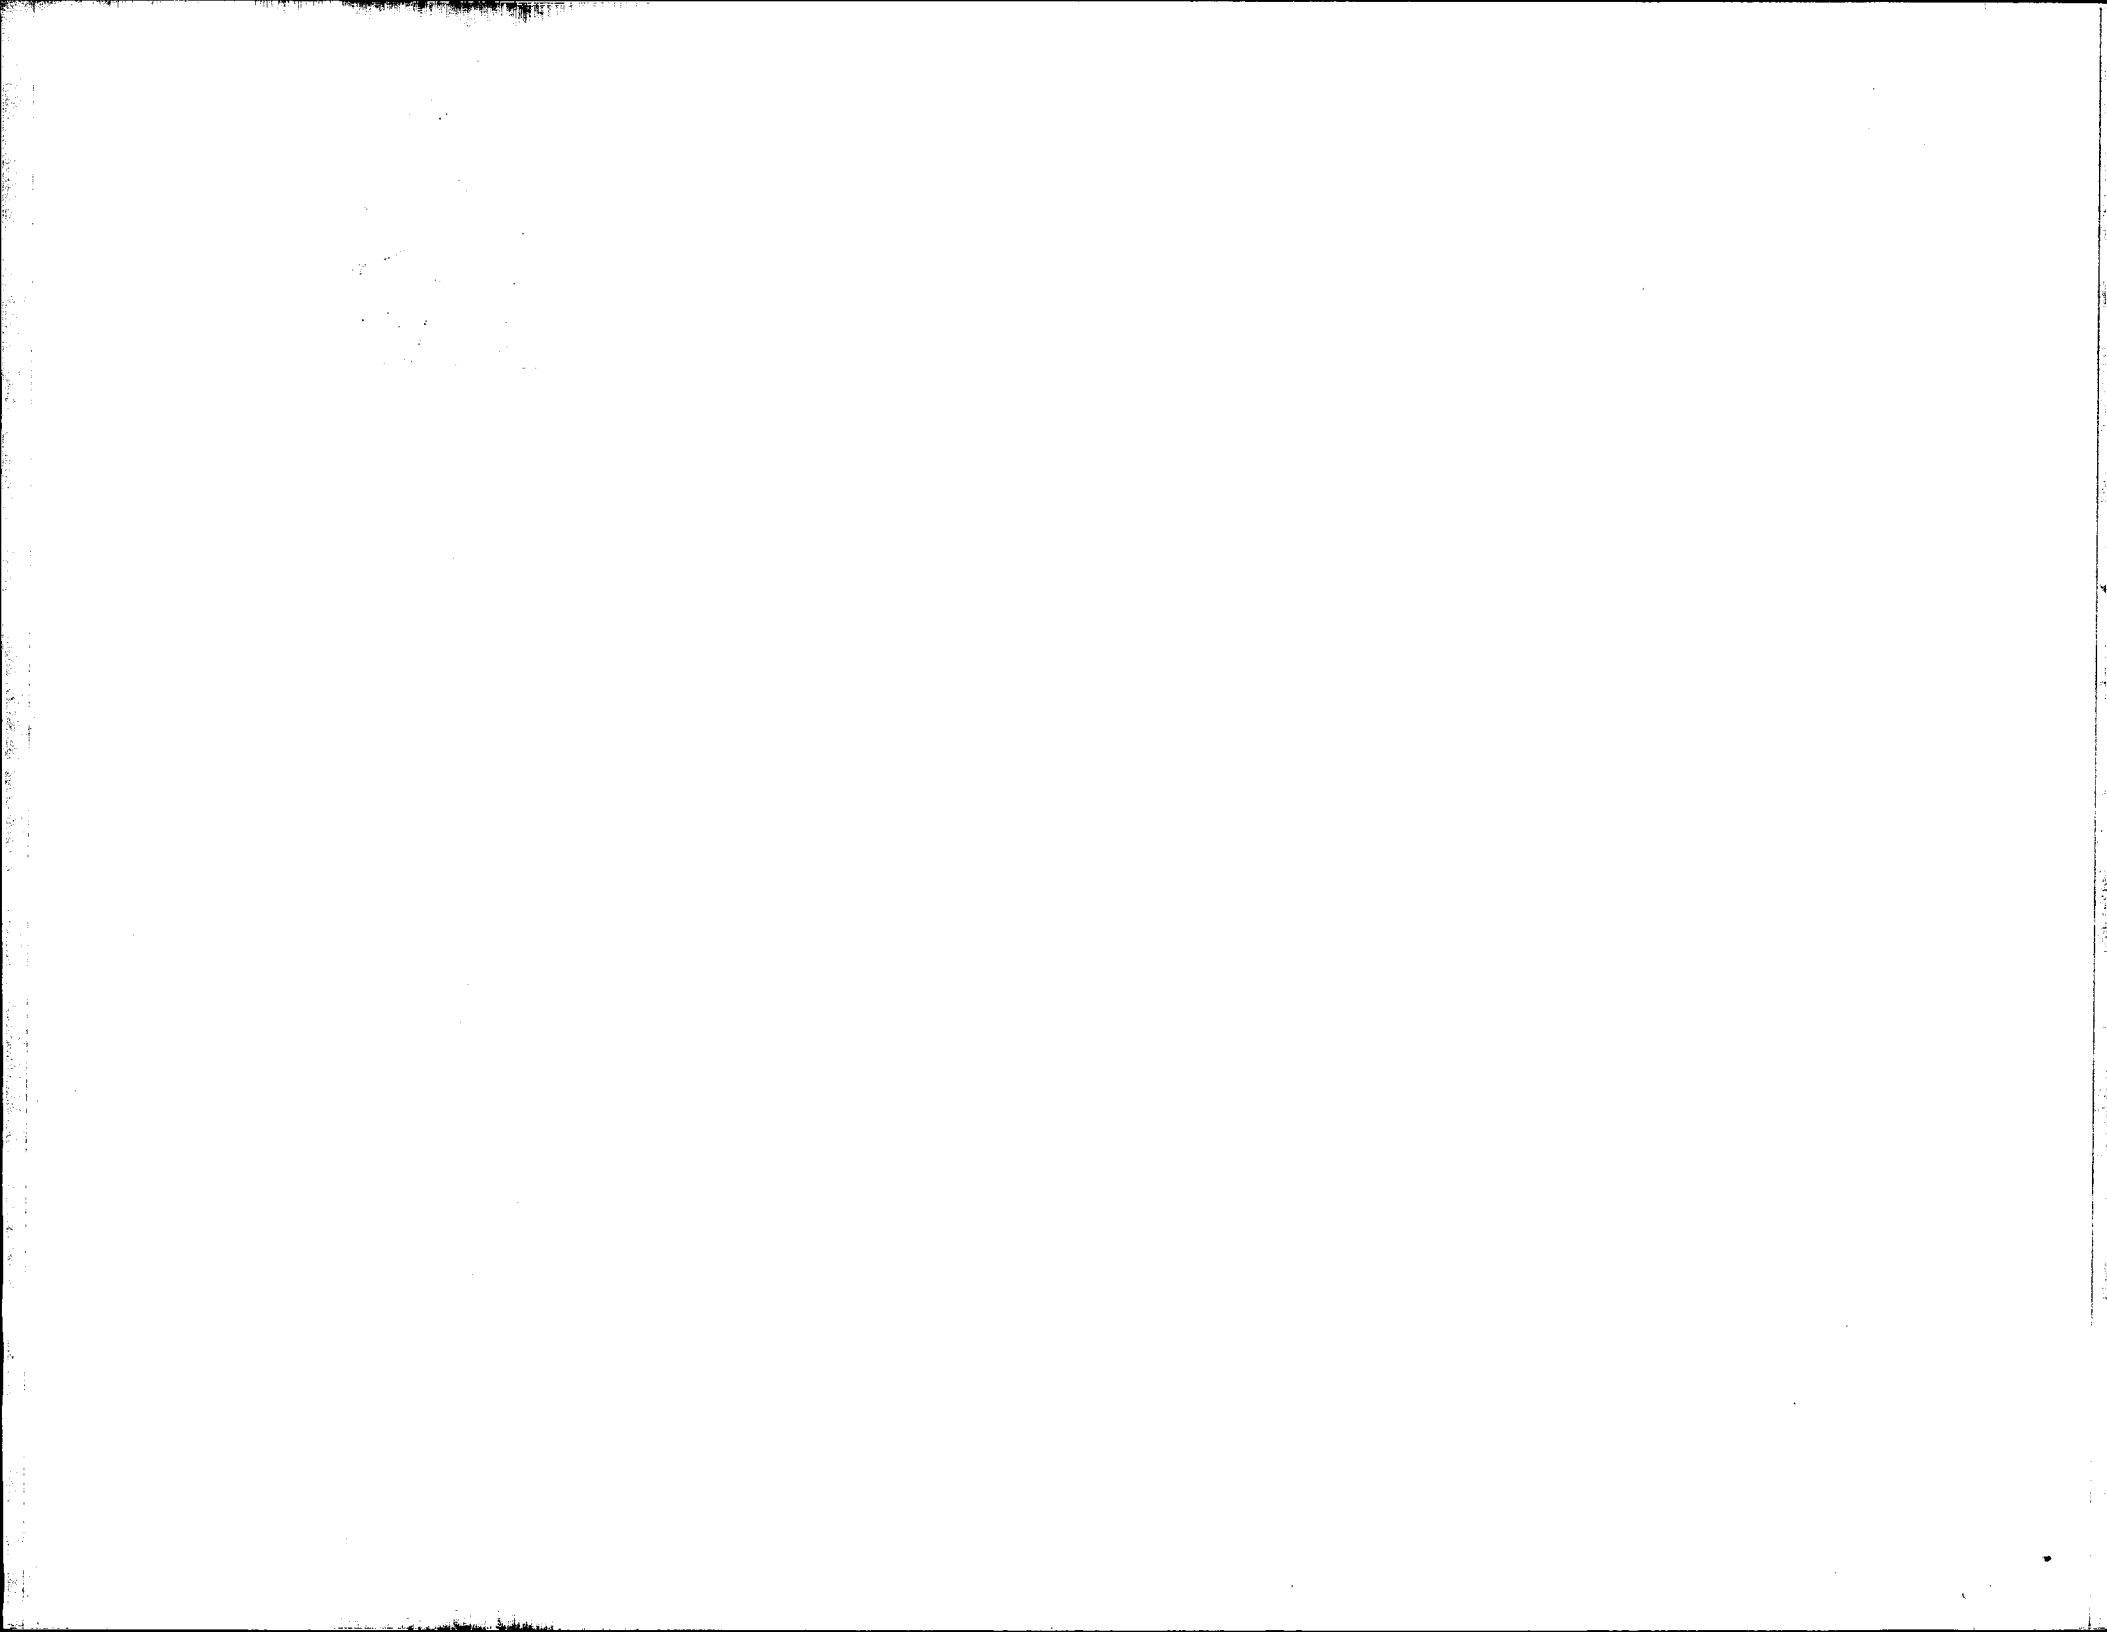




**DART**



DESIGN	BW	DRAWN BY	<i>CP</i>	<b>DART AEROSPACE LTD</b>
CHECKED	<i>#</i>	APPROVED	<i>#</i>	HAWKESBURY, ONTARIO, CANADA
DATE	01.04.19	DRAWING NO.	D2512	REV. D
		TITLE	BASKET LID ASSEMBLY (350/212)	SHEET 2 OF 4
		SCALE	1:20	

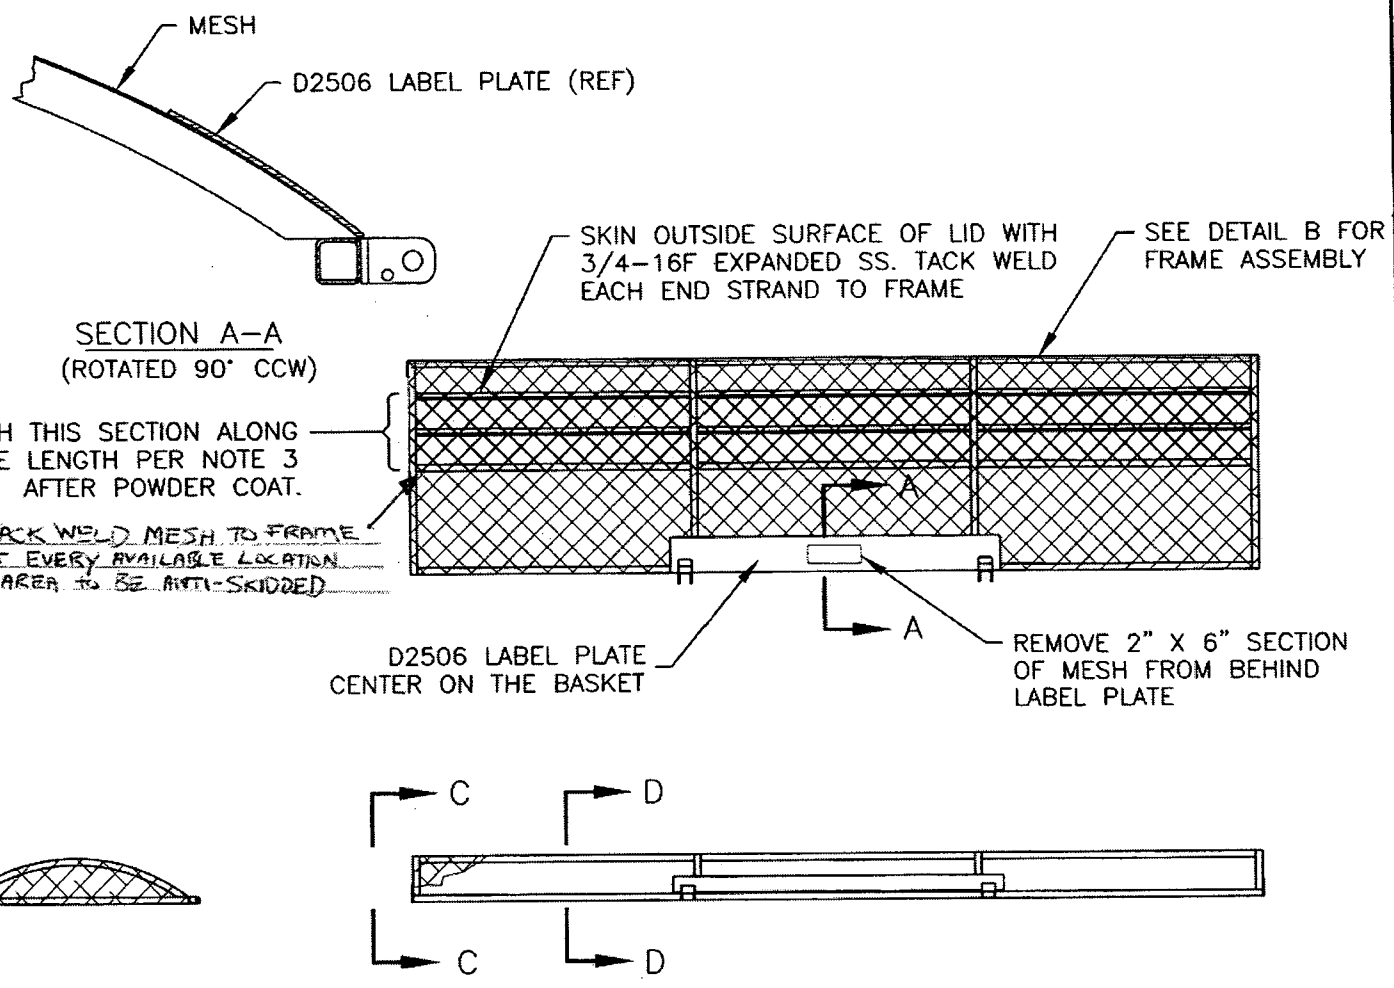

- D2512 BASKET LID ASSEMBLY**
- 1) MESH MATERIAL: 3/4-16F EXPANDED SS
  - 2) FINISH: POWDER COAT ENTIRE ASSEMBLY WHITE (4.3.5.2) PER DART QSI 005 4.3
  - 3) SPRAY PAINT BLACK INSIDE SURFACE  
APPLY BLACK ANTI-SKID TO OUTSIDE SURFACE PER DART QSI 005 4.4
  - 4) TOLERANCES ARE PER DART QSI 018 UNLESS OTHERWISE NOTED
  - 5) ALL DIMENSIONS ARE IN INCHES




**RELEASED**  
UNCONTROLLED COPY  
01.04.2019  
WORK ORDER  
NO. 27816B

Copyright © 1995 by DART Aerospace Ltd  
THIS DOCUMENT IS PRIVATE AND CONFIDENTIAL AND IS SUPPLIED ON THE EXPRESS CONDITION THAT IT IS NOT TO BE USED FOR ANY PURPOSE OR COPIED OR COMMUNICATED TO ANY OTHER PERSON WITHOUT WRITTEN PERMISSION FROM DART Aerospace Ltd.

**DART**



DESIGN	BW	DRAWN BY	DART AEROSPACE LTD
CHECKED	APPROVED	DRAWING NO.	HAWKESBURY, ONTARIO, CANADA
DATE	01.04.19	TITLE	BASKET LID ASSEMBLY (350/212)
REV. D	SHEET 3 OF 4	SCALE	1:20

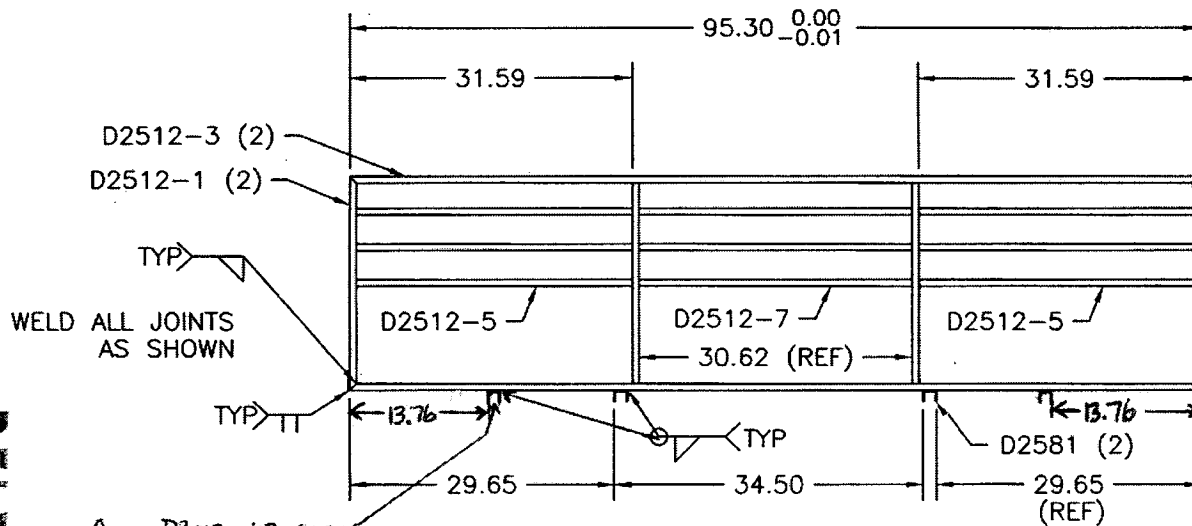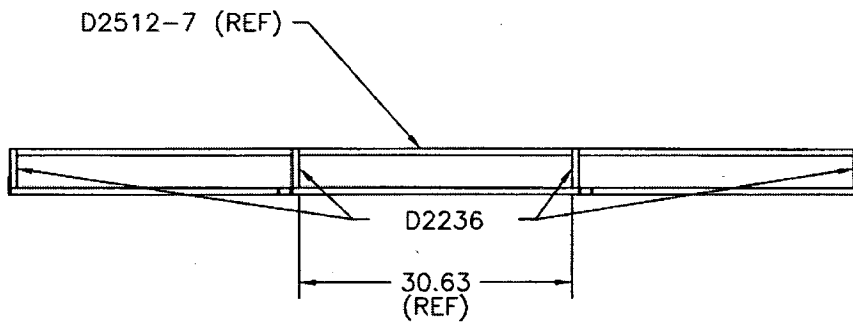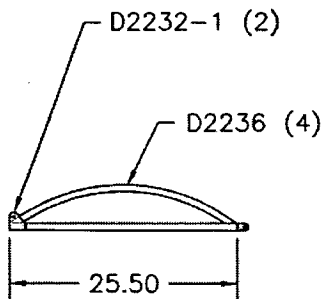

D2012-117 CLEMS  
ADD FOR D130-701-041  
ONLY (2 PLACES)

**DETAIL B**  
FRAMEWORK SHOWN FOR CLARITY  
TOLERANCES ARE PER DART QSI 018 UNLESS OTHERWISE NOTED  
ALL DIMENSIONS ARE IN INCHES


**RELEASED**  
ORIGINAL COPY  
SUBJECT TO AMENDMENT  
WITHOUT NOTICE

WORK ORDER  
NO. 278167


Copyright © 1995 by DART AEROSPACE LTD  
THIS DOCUMENT IS PRIVATE AND CONFIDENTIAL, AND IS SUPPLIED ON THE EXPRESS CONDITION THAT IT IS NOT TO BE USED FOR ANY PURPOSE OR COPIED OR COMMUNICATED TO ANY OTHER PERSON WITHOUT WRITTEN PERMISSION FROM DART AEROSPACE LTD.




DESIGN BW	DRAWN BY UP	DART AEROSPACE LTD HAWKESBURY, ONTARIO, CANADA	
CHECKED #	APPROVED #	DRAWING NO. D2512	REV. D SHEET 4 OF 4
DATE 01.04.19		TITLE BASKET LID ASSEMBLY (350/212)	SCALE 1:8

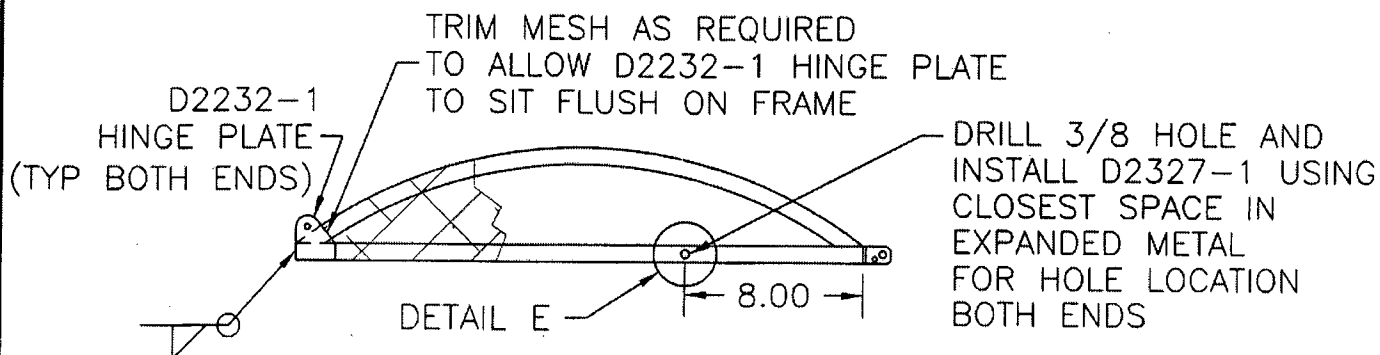

SECTION C-C SIMILIAR BOTH END RIBS

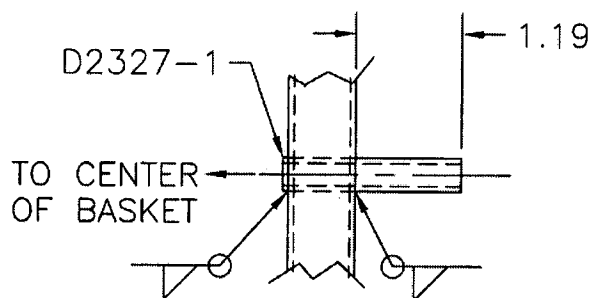

DETAIL E

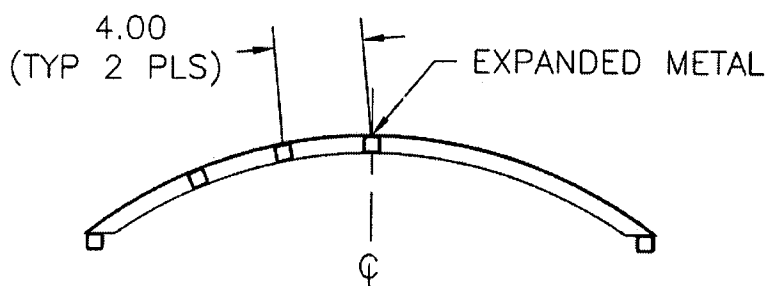

SECTION D-D SAME BOTH CENTER RIBS

SHOP COPY  
RETURN TO  
ENGINEERING  
UNCONTROLLED COPY  
SUBJECT TO AMENDMENT  
WITHOUT NOTICE  
WORK ORDER  
NO. 27816B

Copyright © 1995 by DART AEROSPACE LTD

THIS DOCUMENT IS PRIVATE AND CONFIDENTIAL AND IS SUPPLIED ON THE EXPRESS CONDITION THAT IT IS NOT TO BE USED FOR ANY PURPOSE OR COPIED OR COMMUNICATED TO ANY OTHER PERSON WITHOUT WRITTEN PERMISSION FROM DART AEROSPACE LTD.